

AS BUILTS

4<sup>TH</sup> FLOOR TEST FIT  
22,453 RSF


111  
TOTAL  
HEADCOUNT

28  
PRIVATE  
OFFICES

66  
CONFERENCE  
ROOM SEATS

WEST 52<sup>ND</sup> STREET

AVENUE OF THE AMERICAS

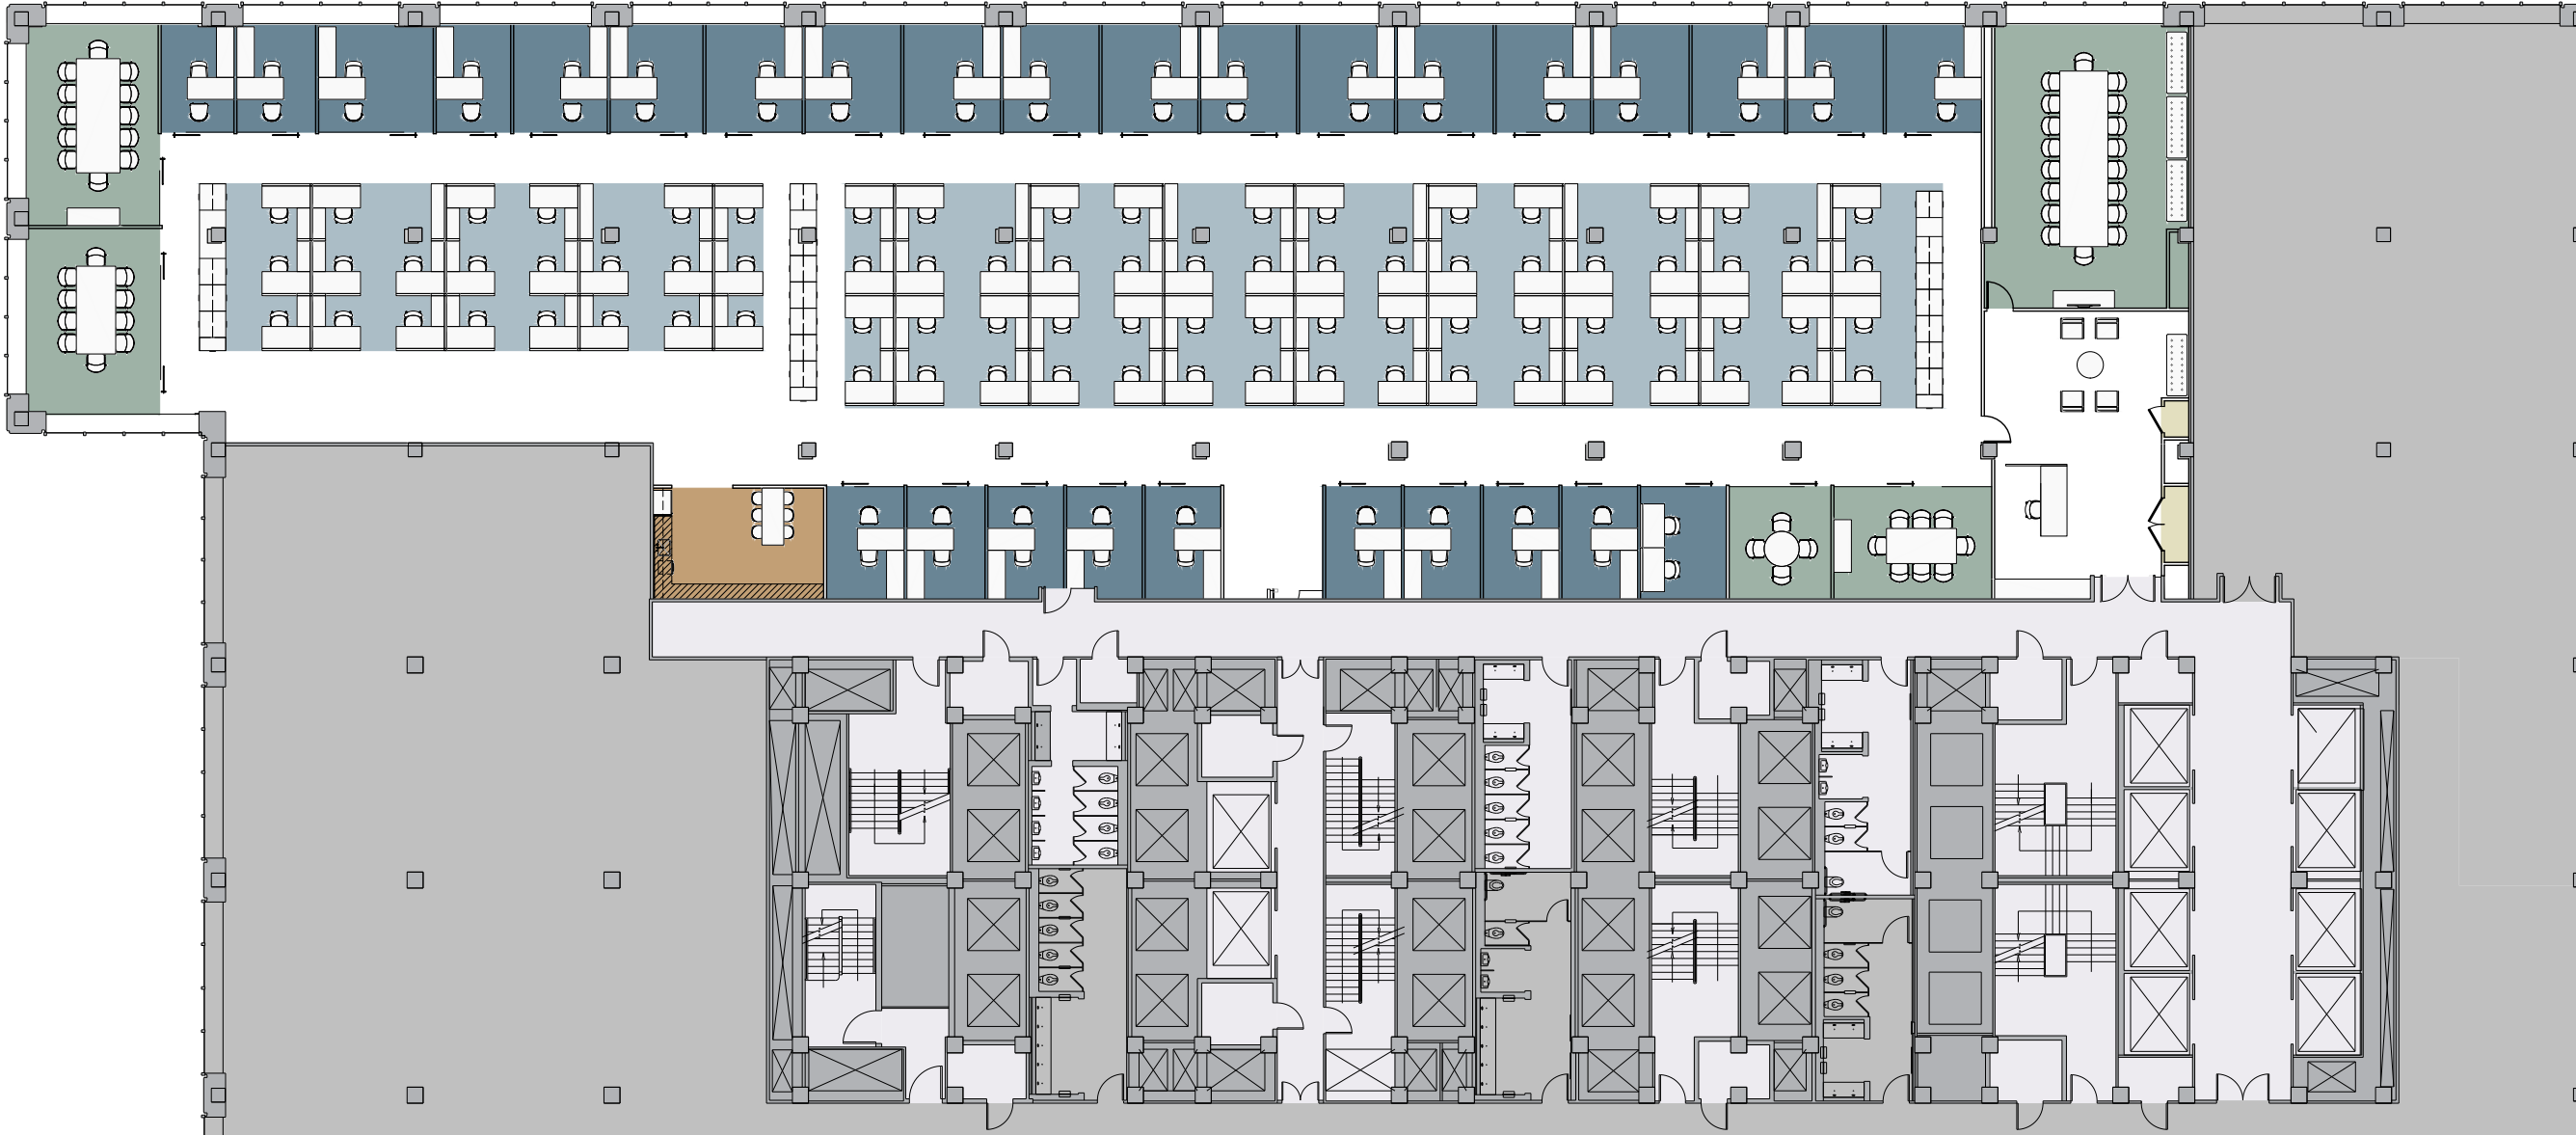

- |            |               |
|------------|---------------|
| OFFICE     | COLLABORATIVE |
| BENCHING   | PHONE         |
| CONFERENCE | SUPPORT       |